




MANUAL STATION DIAGRAM

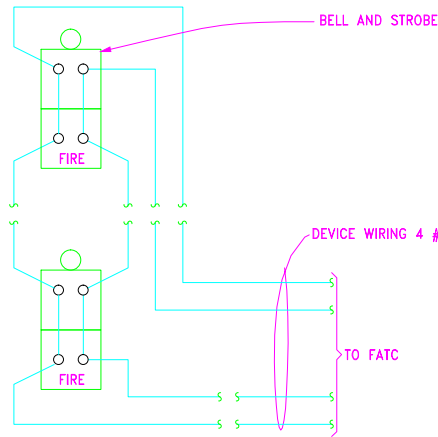


BELL AND STROBE DIAGRAM

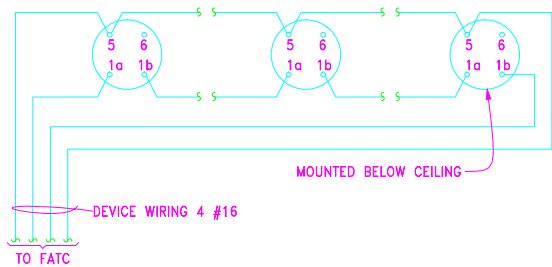


SMOKE DETECTOR DIAGRAM

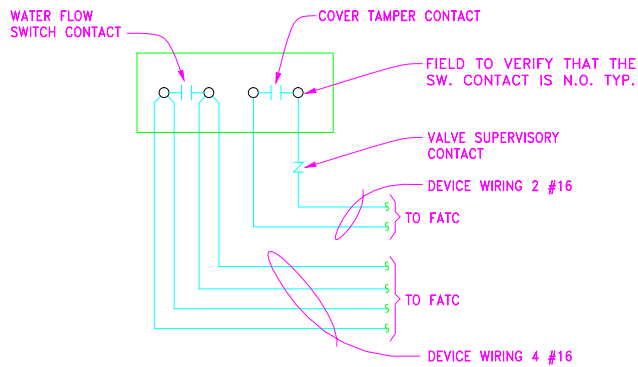


WATERFLOW SWITCH DIAGRAM

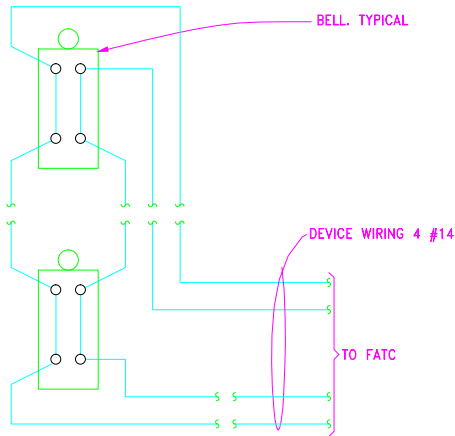

BELL DIAGRAM  
NOT TO SCALE

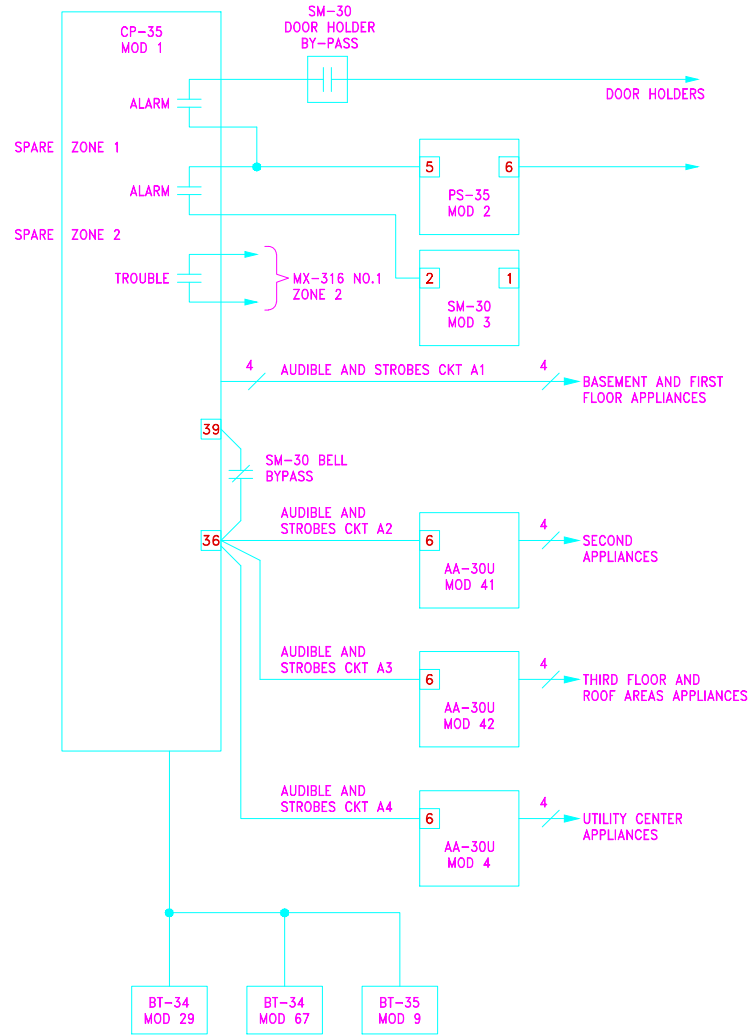

AUDIBLE AND VISUAL CIRCUITS  
NOT TO SCALE

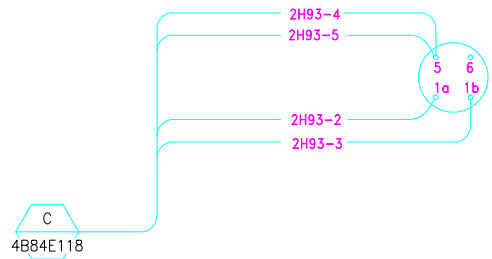

IONIZATION SMOKE DETECTOR

PROFESSIONAL SEAL (IF REVISION, APPLIES ONLY TO REVISED WORK)	AS BUILT REVISION D 05/15/2009								84	FIRE ALARM		DRAWN BY	LDD	DATE	3/6/2002
												CHECKED BY	MCG	3/6/2002	
												APPROVED BY	MCG	3/6/2002	
												CAD FILE PATH 00019261			
												SCALE As Noted			
												DRAWING NO.			SHEET
												4B84E120D			
ISSUE (PROGRESS, ESTIMATE, BID, CONSTRUCTION, CONFORMED, REVISION, AS-BUILT)		REVISION NUMBER	DRAWN BY	CHECKED BY	APPR'D BY	DATE	REMARKS	UNIVERSITY OF CALIFORNIA LAWRENCE BERKELEY NATIONAL LABORATORY FACILITIES DEPARTMENT		PROJECT NO.	WG0721	1 OF 1			
		A	MRC	AD	MCG	8/15/03	PHASE II FIRE ALARM SYSTEM UPGRADE								